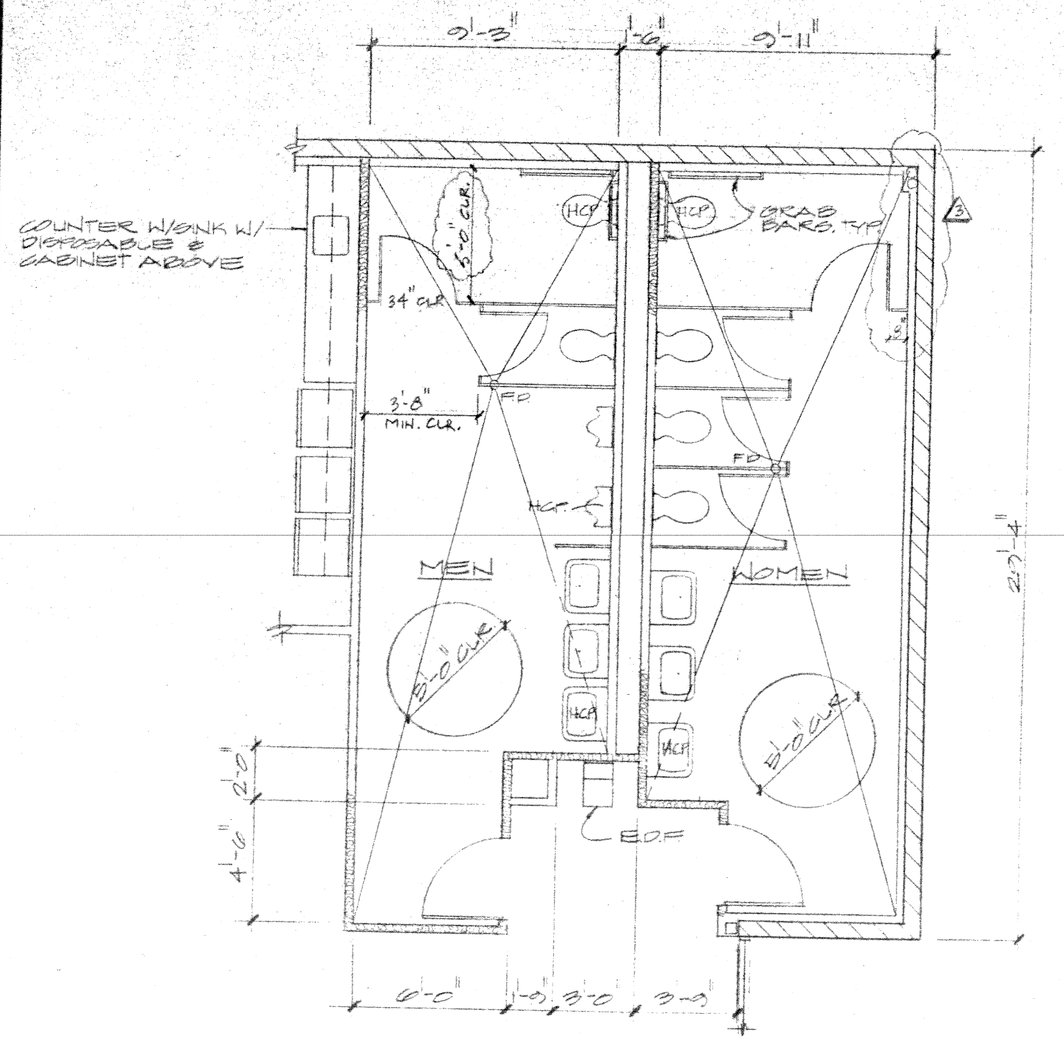

1/4" TOILET PLAN

FOR ADDITIONAL HCP NOTES SEE SHEET 'X'

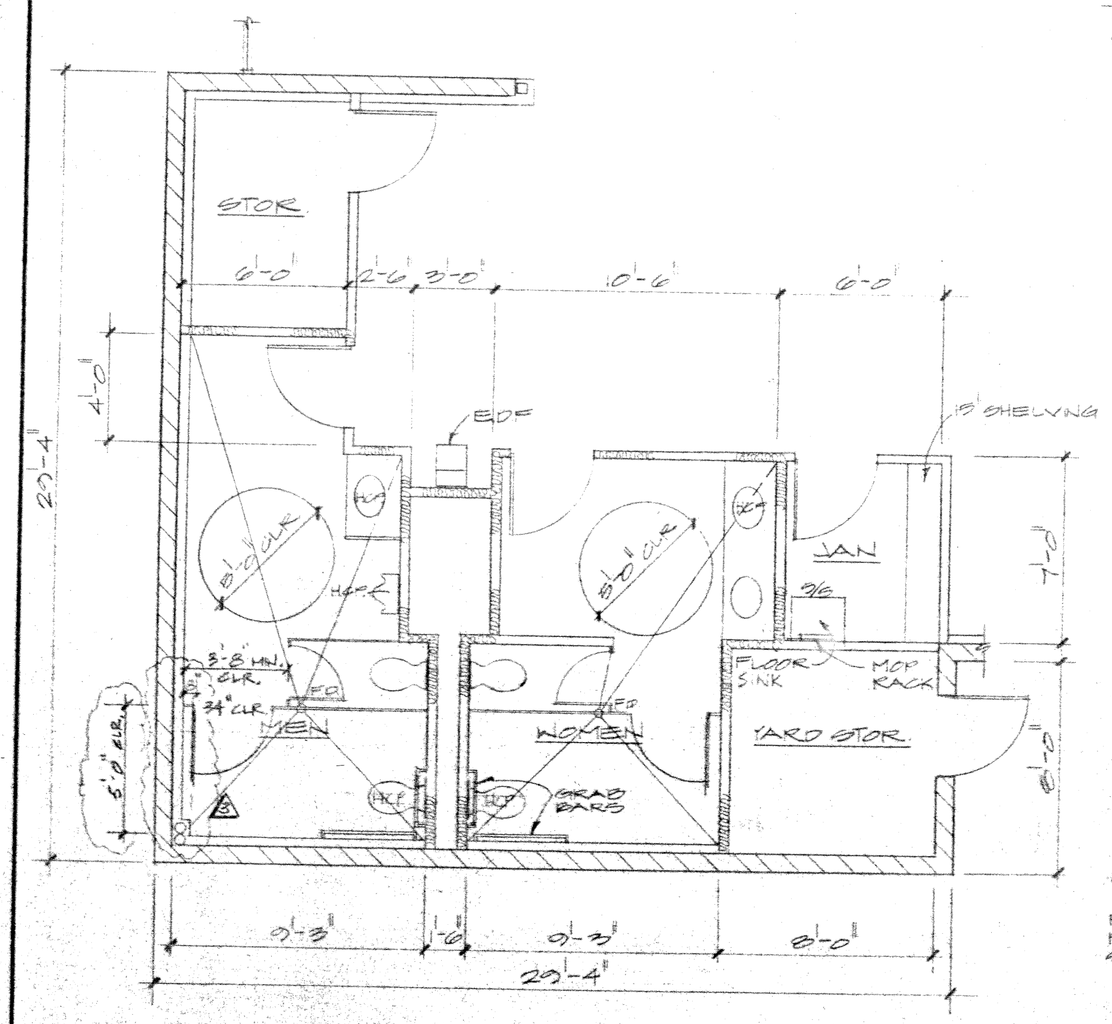

1/4" TOILET PLAN

FOR ADDITIONAL HCP NOTES SEE SHEET 'X'

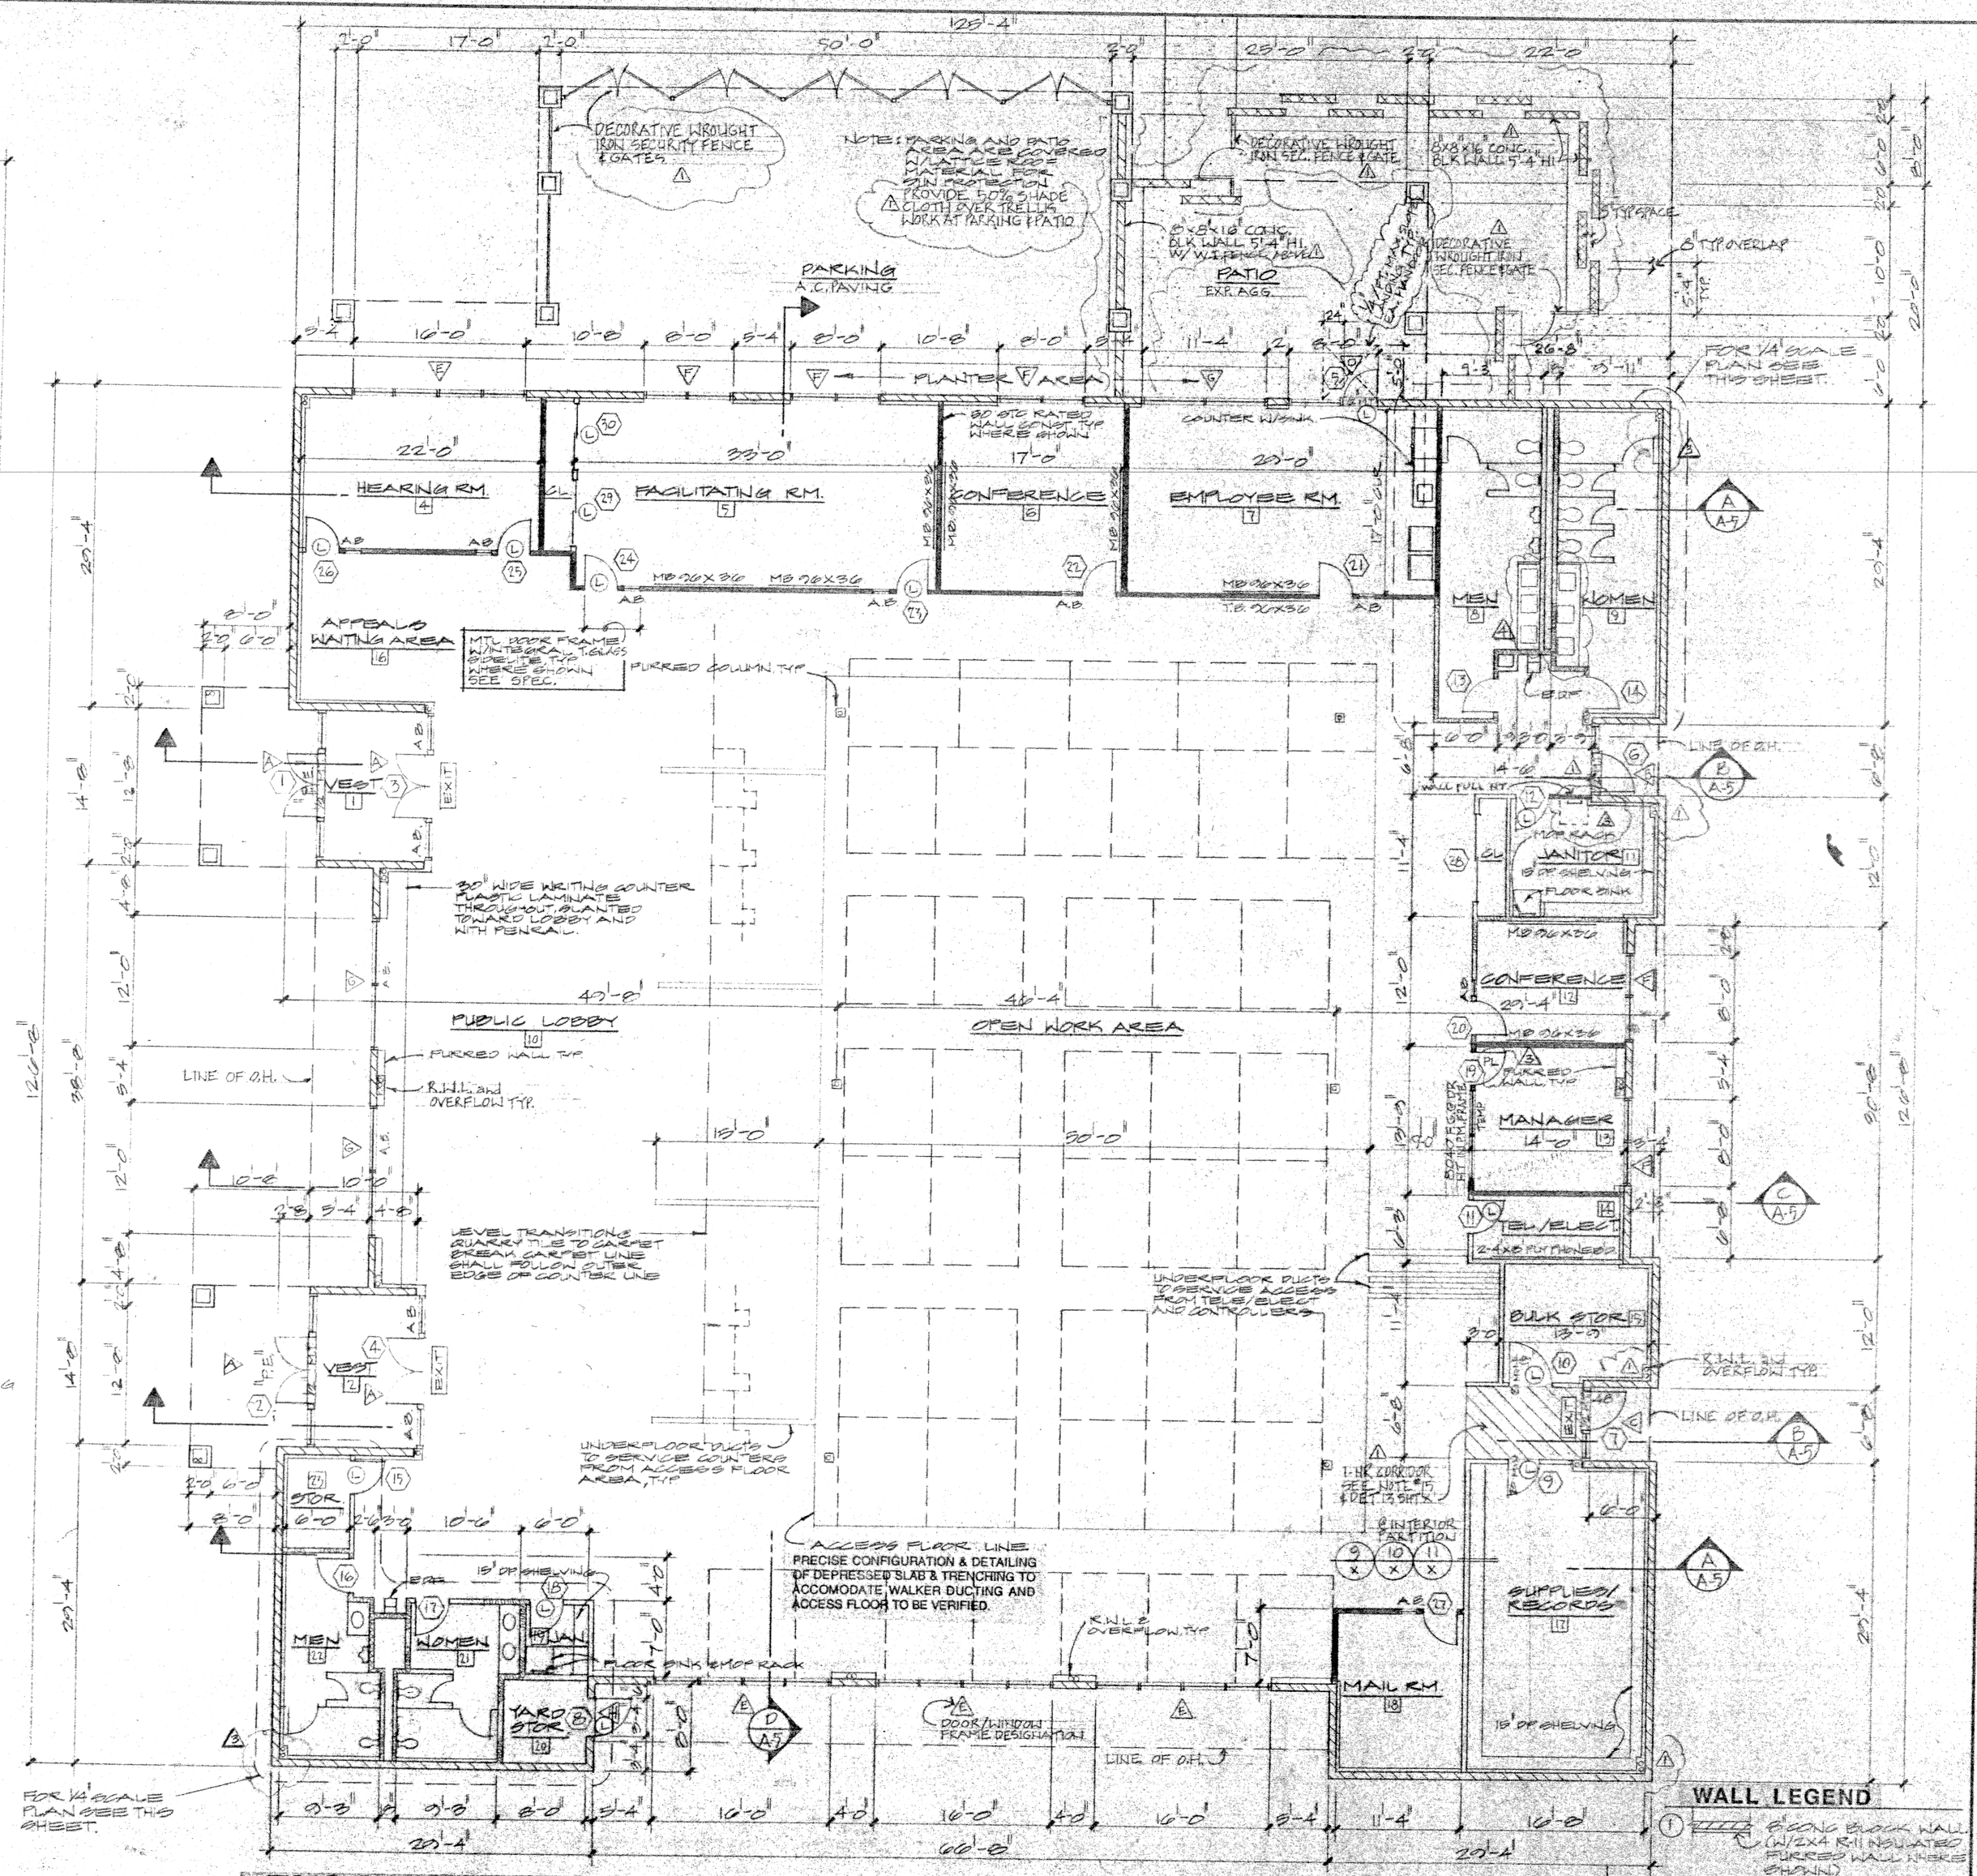

FLOOR PLAN

1. FOR GENERAL NOTES, INTERIOR IMPROVEMENT DETAILS, TOILET ROOM NOTES AND DETAILS, SEE SHEET-X.
2. ALL DOORS SHALL COMPLY WITH NOTES #7 & #8, SHEET-X.
3. "P.E." DESIGNATES "PRIMARY ENTRANCE". SEE NOTE #6, SHEET-X.
4. EXITING, EXIT SIGNS, & EXIT DOORS SHALL COMPLY TO CHAPTER 33 OF THE UBC.

1/8" = 1'-0"

ADDED KEYED LOCKSETS TO DOORS #5, 8, 9, 10, 11 & 12. ADDED PRIVACY LOCK, #19.

WALL LEGEND

1. 8" CONC BLOCK WALL (W/2X4 R-11 INSULATED FURRED WALL WHERE SHOWN)
2. 2X4 @ 16" STUD PARTITIONS CEILING HEIGHT
3. 2X4 PART W/SOUND INSULATION
4. 2X4 FULL HT W/INSUL DR W/KEYED LOCKSET PRIVACY LOCK

REVISIONS	BY
AS BUILT 8/5/93	RJ
1/15/93	LM
2nd P/C 10/20/92	LM
E.D.D. CHANGES 10/8/92	JS
P.C. 9-30-92	JS

Leo McGlade & associates, inc.
3417 Arden Way Suite A Sacramento, CA 95825 (916) 488-8380

FLOOR PLAN

NEW OFFICE QUARTERS EDD - JSUI

CORNER OF DR. CARREON & CALHOUN
INDIO, CA.

Date 5/26/92
Scale NOTED
Drawn R.J.
Job E-13-71
Sheet A-2
Of Sheets

INDIO JS/UT

24 X 36 PRINTED ON NO. 1000H CLEARPRINT